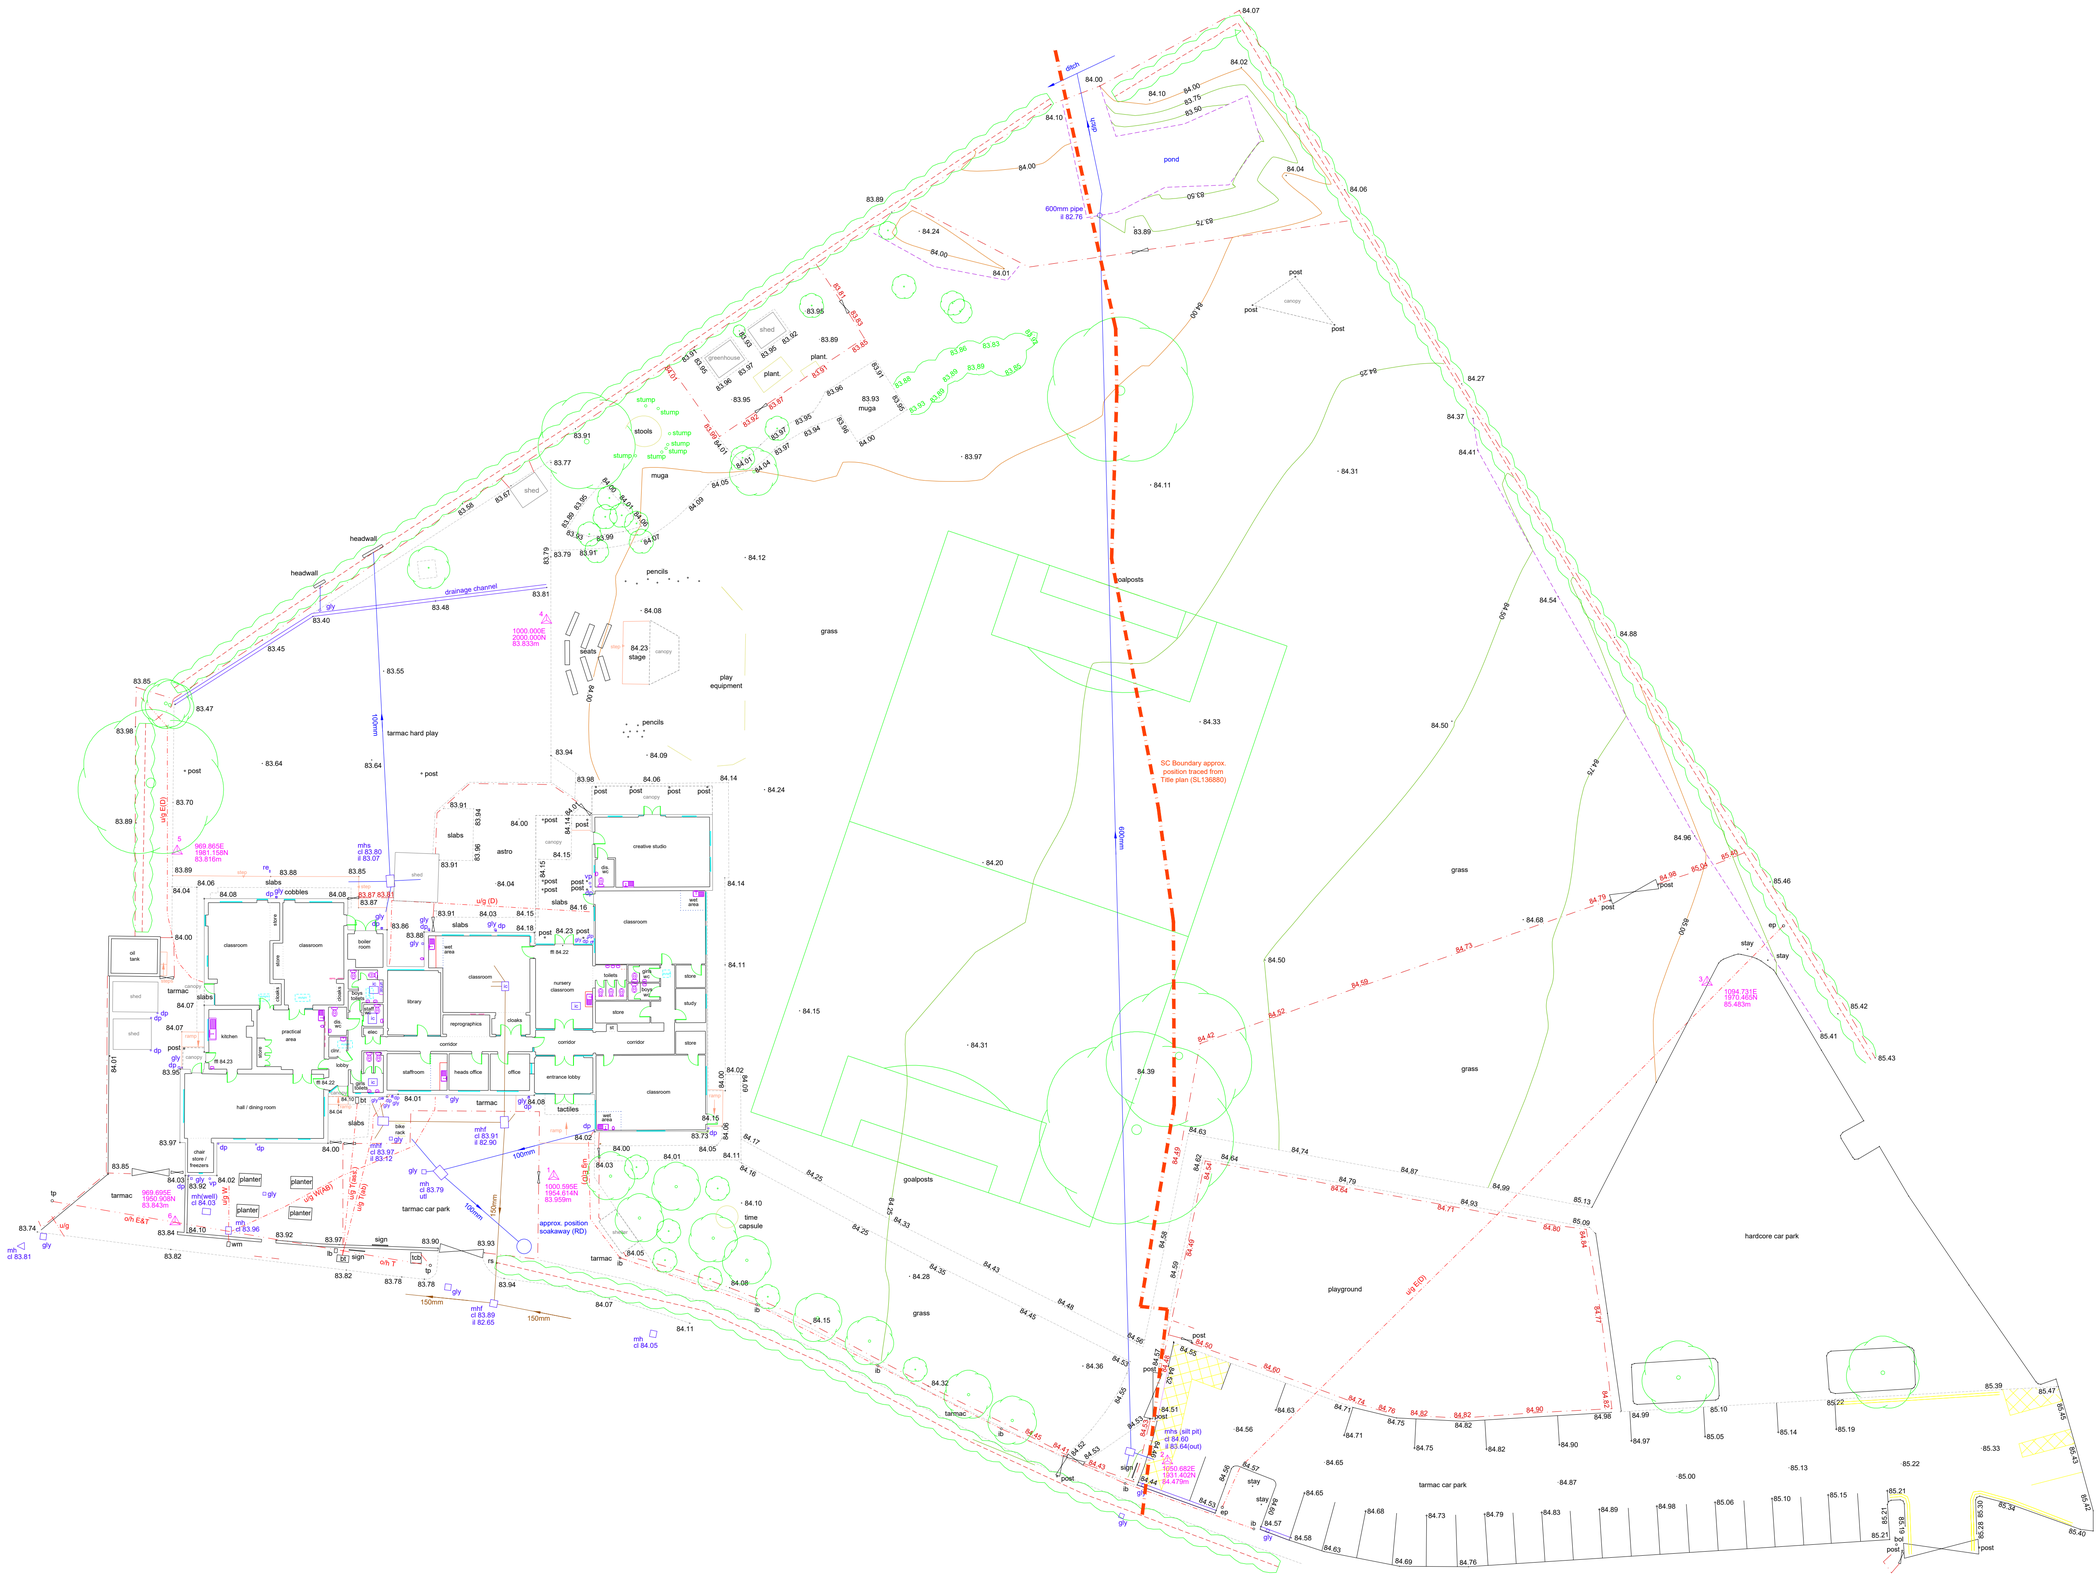

DO NOT SCALE FROM THIS DRAWING

© Crown copyright and database rights 2023 Ordnance Survey 100049049

Survey Features Legend

ab	airbrick	ib	illuminated bollard
catv	cable tv cover	thl	threshold level
bo	bollard	il	invert level
cl	cover level	th	trial hole
bt	telecom cover	lp	lamp post
d.c.	drainage channel	ult	unable to lift
rs	road sign	ffl	finished floor level
dp	downpipe	vp	vent pipe
re	rodding eye	mh	manhole
er	earth rod	wo	washout
st	stop tap	mhc	combined manhole
ep	electric pole	wm	water meter
sl	silt level	mhs	storm manhole
fh	fire hydrant	wl	water level
tp	telegraph pole	mhf	foul manhole
gly	gulley	ic	inspection chamber
tl	traffic light		

Utility Services Legend

Detected (D), As-Built (AB), Record Drawing (RD)
Statutory Authority Records (SA)

o/h	Overhead Service
u/g	Underground Service
E	Electric
T	Telecom
W	Water
G	Gas
?	Unknown

INFORMATION ON UNDERGROUND SERVICES IS BELIEVED TO BE CORRECT BUT NO GUARANTEE IS GIVEN OR IMPLIED

Building Survey Notes

- Floor plans produced with MBS survey software, using both laser and tape measurements.
- All dimensions shown in millimetres unless otherwise stated.
- Accuracy is as specified in RICS guidance notes at 1:100 survey scale or better.

REV	AMENDMENT	DW & AM DD.MM.YYYY DRAWN	CHKD
6	COMPLETE SITE & BUILDING UPDATE		

Shropshire Council

www.shropshire.gov.uk 0345 678 9000

Property Services Group
psg.shropshire.gov.uk
01743 281079

NEWTOWN CoE PRIMARY
NEWTOWN, WEM
SY4 5NU
PROPERTY NO: 1510

RECORD DRAWING

TOPOGRAPHICAL & MEASURED BUILDING SURVEY PLAN

DWG. STATUS				
SCALE	1:250			@ A1
DRAWN BY	D.ENGLER & D.GUNN			
DATE	03.2010			
UPDATED	20.04.2023		REV.	6
AREA	PROP.	PHASE	AEMFS	SHEET
173	001	05	S	01